


N 382,500
E 2,124,500
E 2,125,000
E 2,125,500
E 2,126,000
E 2,126,500

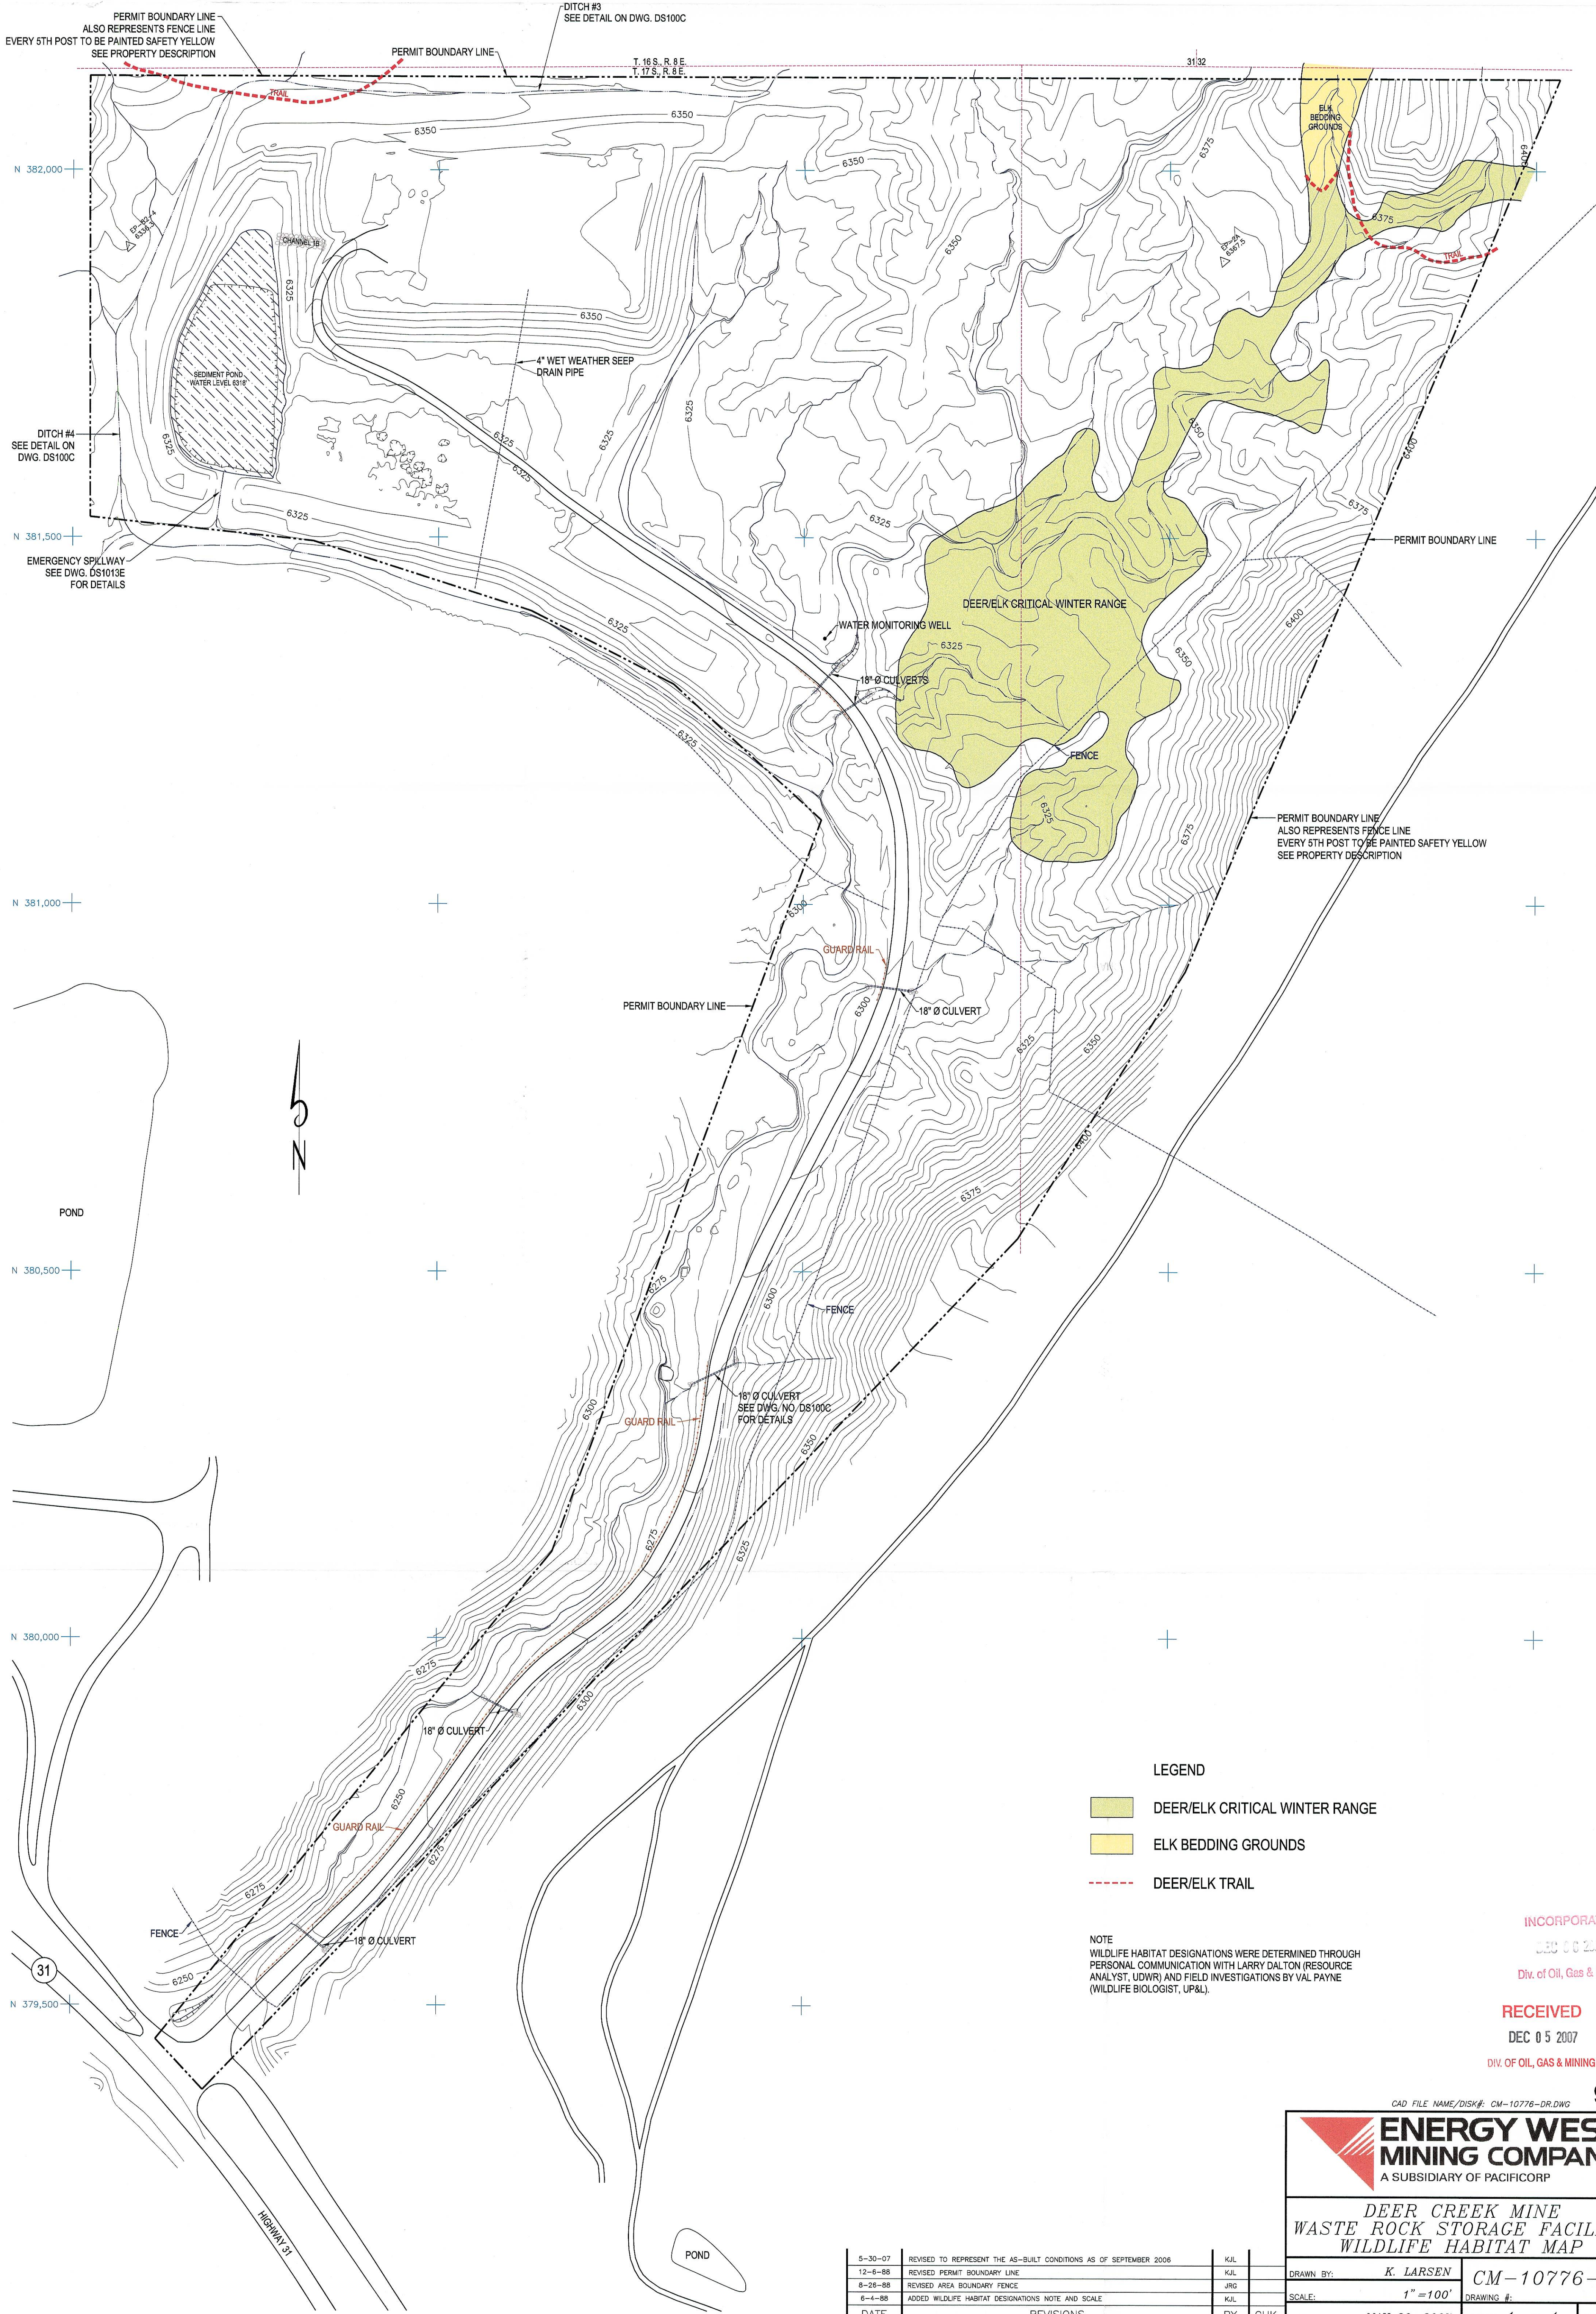

LEGEND

- DEER/ELK CRITICAL WINTER RANGE
- ELK BEDDING GROUNDS
- DEER/ELK TRAIL


NOTE
WILDLIFE HABITAT DESIGNATIONS WERE DETERMINED THROUGH
PERSONAL COMMUNICATION WITH LARRY DALTON (RESOURCE
ANALYST, UDWIR) AND FIELD INVESTIGATIONS BY VAL PAYNE
(WILDLIFE BIOLOGIST, UP&L).

INCORPORATED
DEC 05 2007
Div. of Oil, Gas & Mining

RECEIVED
DEC 05 2007
DIV. OF OIL, GAS & MINING

9-1

CAD FILE NAME/DISK#: CM-10776-DR.DWG

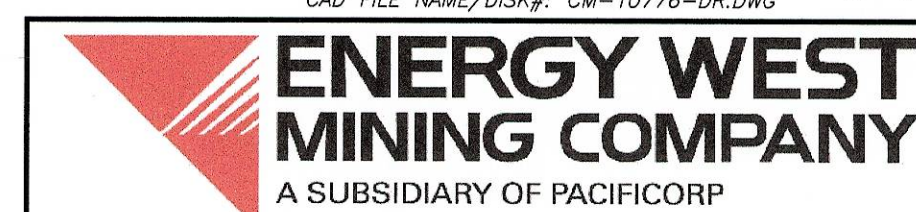

DEER CREEK MINE
WASTE ROCK STORAGE FACILITY
WILDLIFE HABITAT MAP

DRAWN BY: K. LARSEN
SCALE: 1" = 100'
SHEET 1 OF 1
REV. _____

5-30-07	REVISED TO REPRESENT THE AS-BUILT CONDITIONS AS OF SEPTEMBER 2006	KJL
12-6-88	REVISED PERMIT BOUNDARY LINE	KJL
8-26-88	REVISED AREA BOUNDARY FENCE	JRG
6-4-88	ADDED WILDLIFE HABITAT DESIGNATIONS NOTE AND SCALE	KJL
DATE	REVISIONS	BY CHK. DATE

MAY 30, 2007
SHEET 1 OF 1
REV. _____